




Facilities Notice

Capital Development & Delivery | Facilities Management
Saunders Building, PO Box 1700 STN CSC Victoria BC V8W 2Y2 Canada
T 250-721-7591 | www.uvic.ca/fmgt

Title:	Fraser Building – Main Entrance Closure
Location:	Fraser Building – Main Entrance
Description:	<p>The Fraser Building main entrance will be closed October 4th & 5th as Chandos Construction completes flooring work at the connection to the New Wing.</p> <p>The Fraser Building will remain open and can be accessed using the South entrance doors as indicated on the markup below.</p> <p>Please follow directions of posted signage.</p>
Time frame:	Saturday, October 4, 2025 – Sunday, October 5, 2025, 7:00am to 5:00pm
FMGT contact:	Tristan Lowenberger, Associate Director
Email address:	tristanlowenberger@uvic.ca
Phone:	250-661-0599

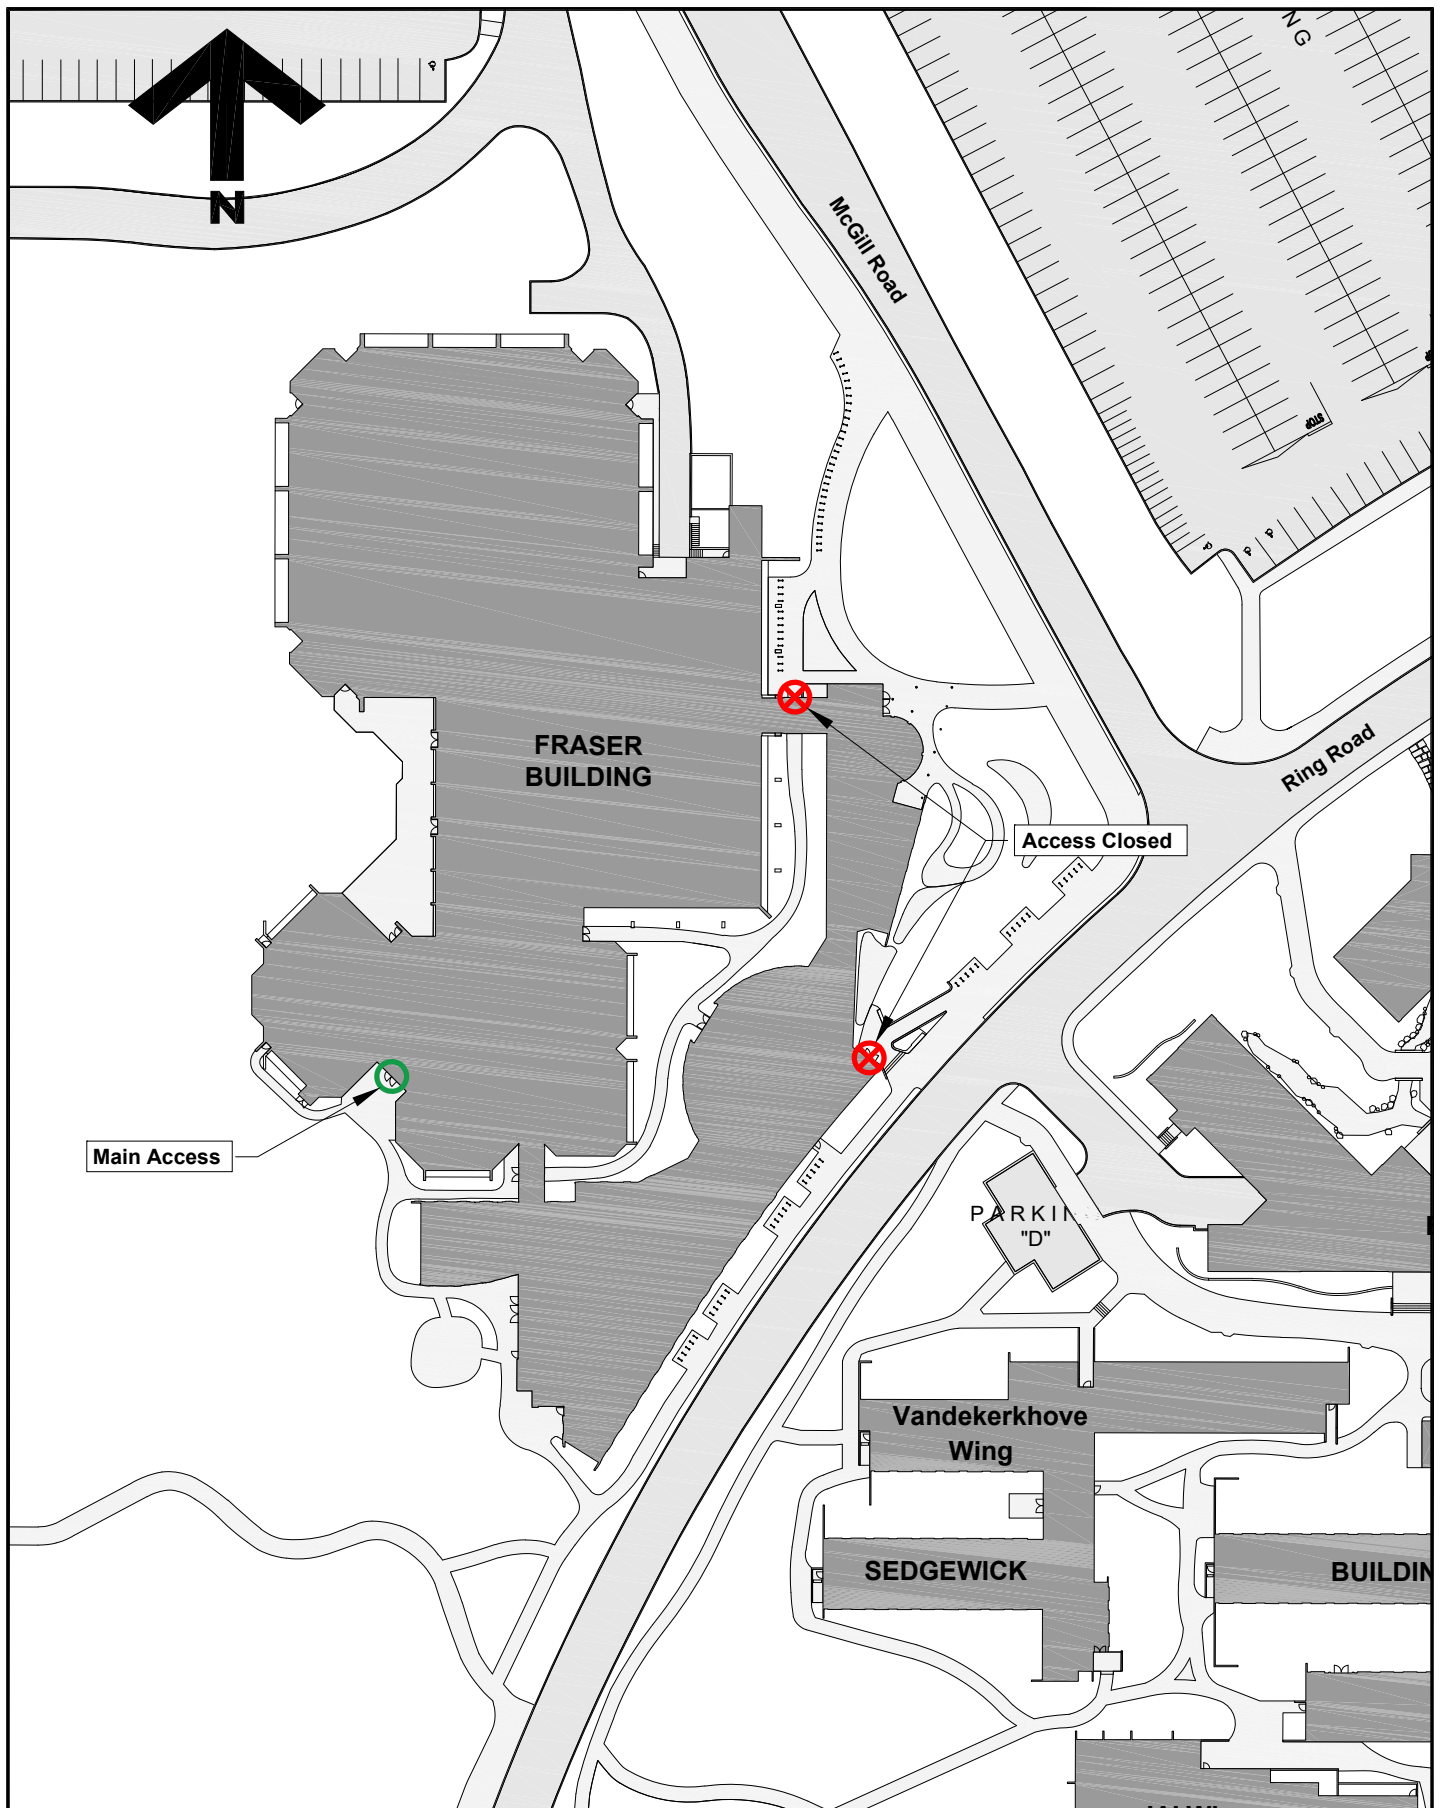

**University
of Victoria**

Facilities Management

Notes:

Title:

**Fraser Building
Temporary Closures
Project Notice**

Date: **26 September 2025**

Scale: **1:1000**

Drawn By: **JW**

Project Number: **20-04526**

Drawing No. **SK1**